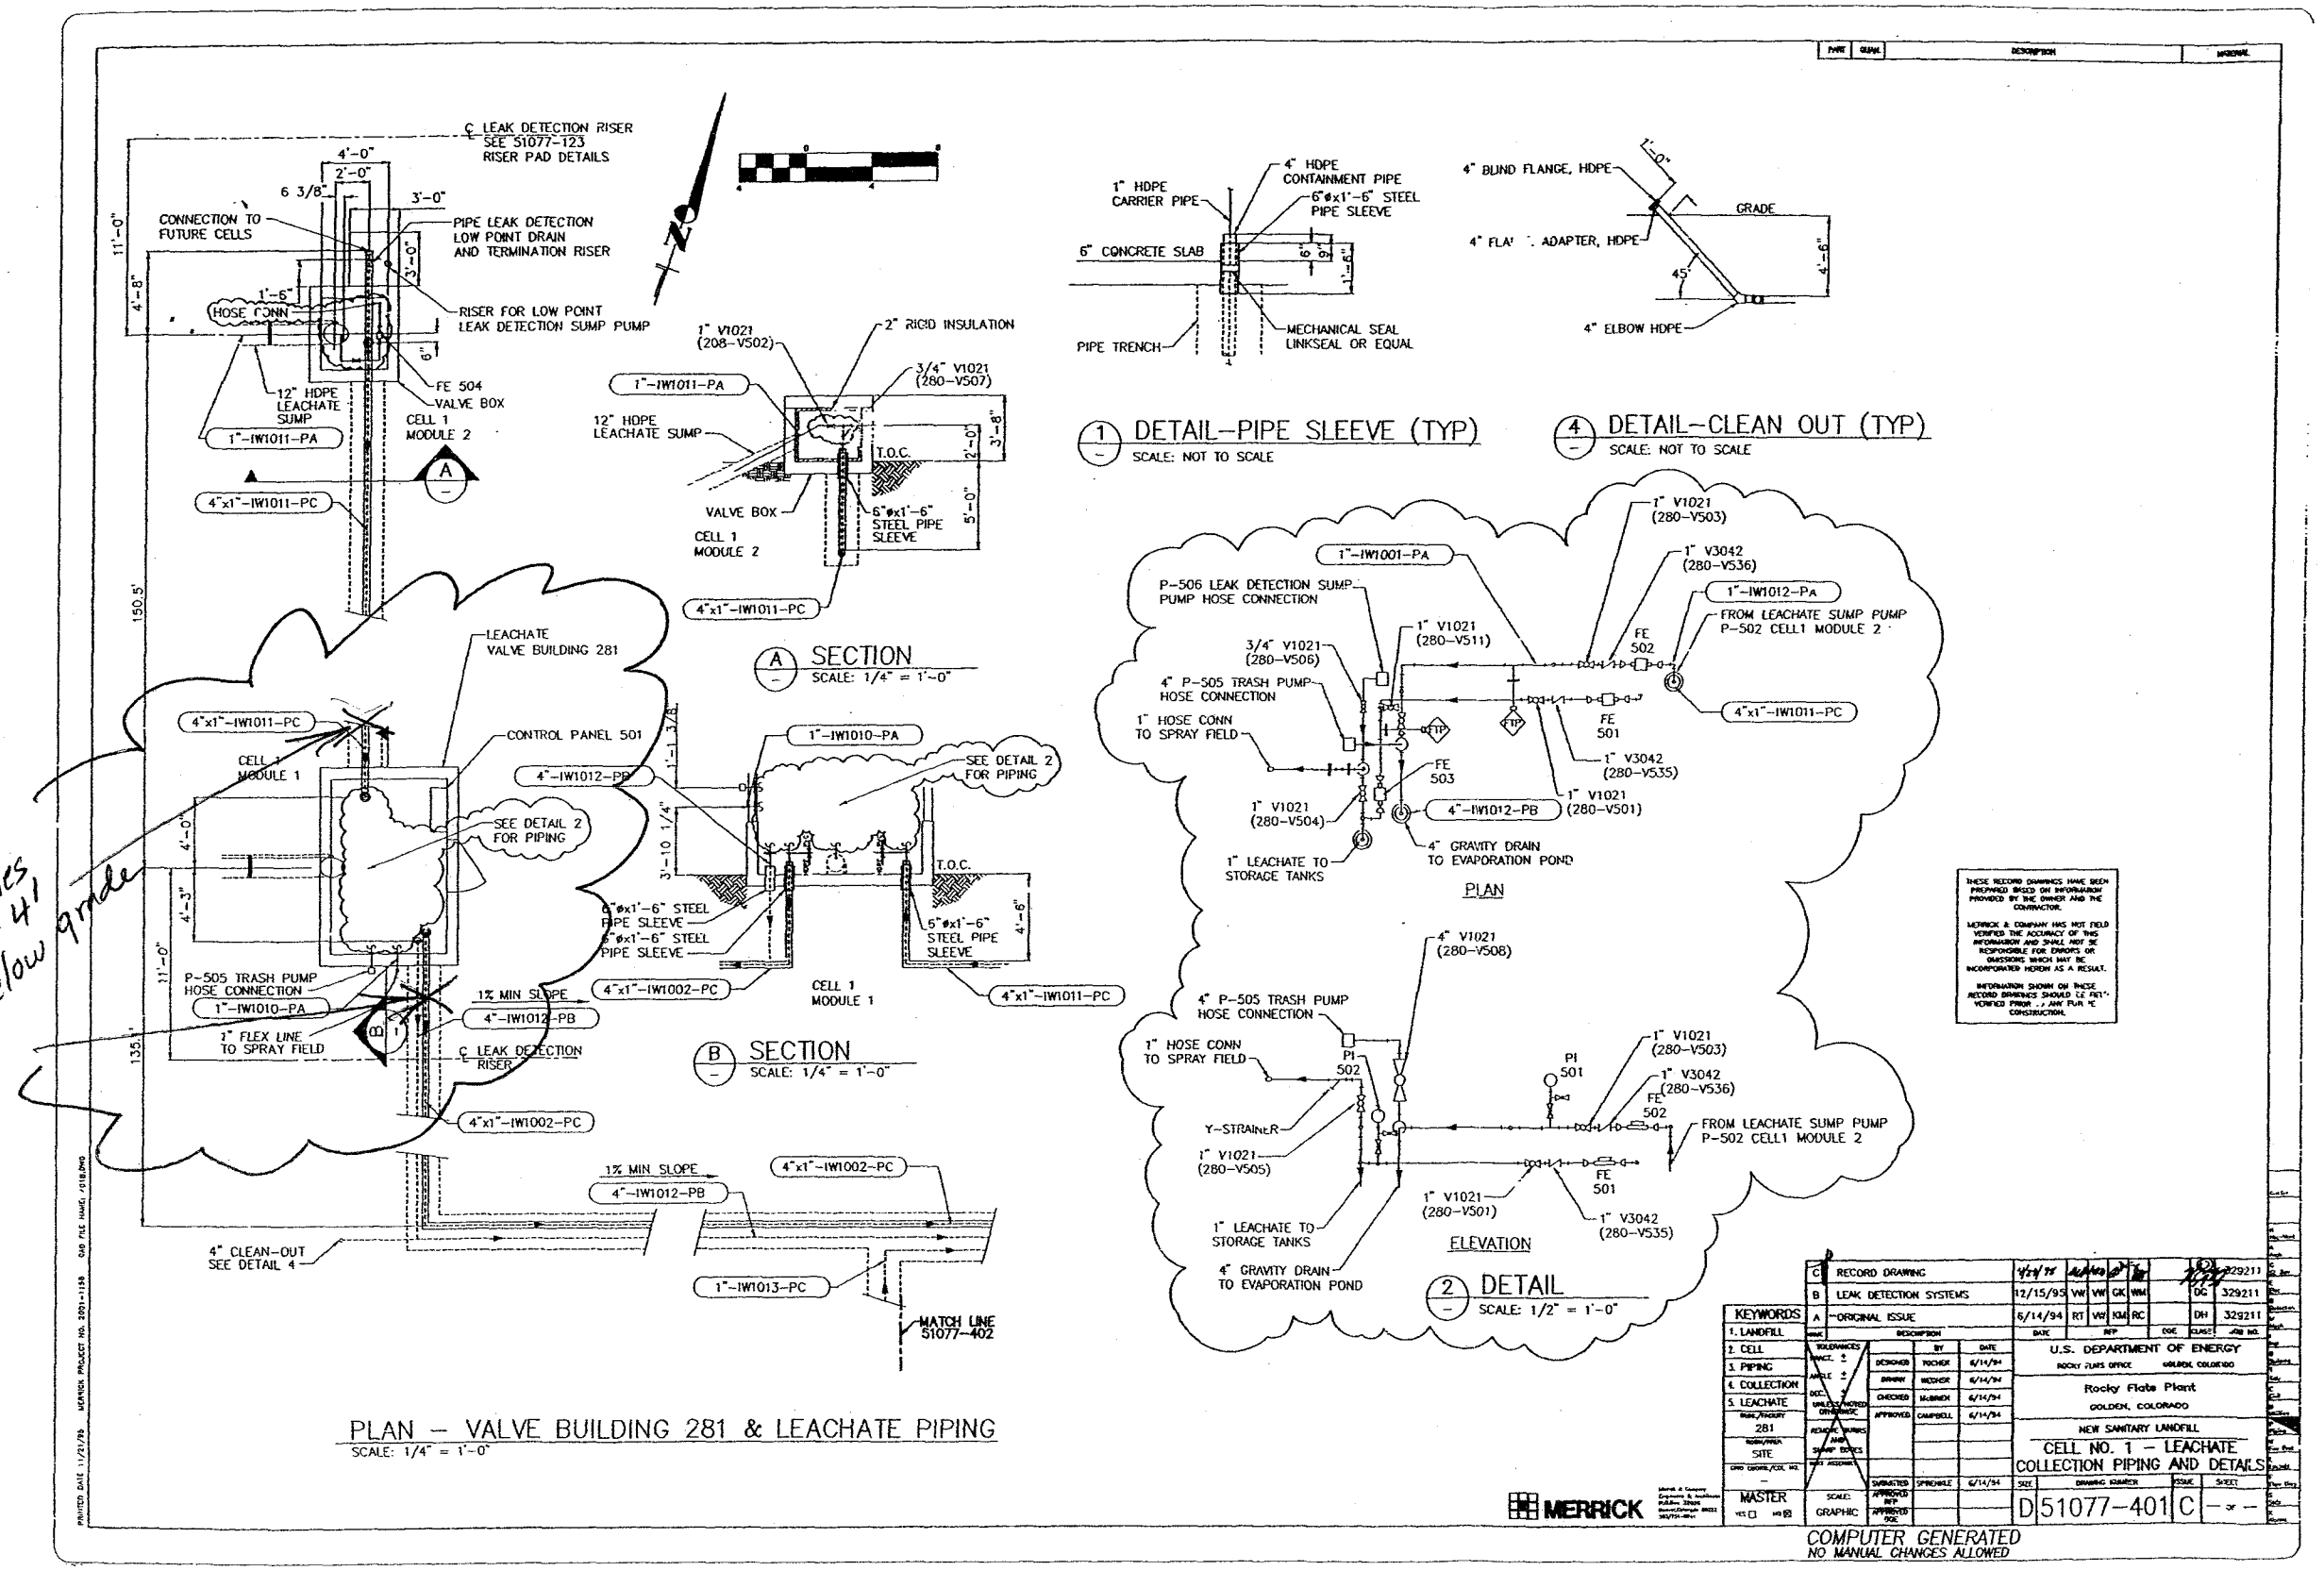

lines at 41 below grade

THESE RECORD DRAWINGS HAVE BEEN PREPARED BASED ON INFORMATION PROVIDED BY THE OWNER AND THE CONTRACTOR.

MERRICK & COMPANY HAS NOT FIELD VERIFIED THE ACCURACY OF THIS INFORMATION AND SHALL NOT BE RESPONSIBLE FOR ERRORS OR OMISSIONS WHICH MAY BE INCORPORATED HEREIN AS A RESULT.

INFORMATION SHOWN ON THESE RECORD DRAWINGS SHOULD BE FIELD VERIFIED PRIOR TO ANY PLAN OF CONSTRUCTION.

C	RECORD DRAWING	4/24/95	[illegible]	[illegible]	[illegible]	[illegible]	[illegible]	[illegible]	329211
B	LEAK DETECTION SYSTEMS	12/15/95	VW	VW	GK	WM		DG	329211
A	ORIGINAL ISSUE	6/14/94	RT	VW	KM	RC		DH	329211

KEYWORDS: 1. LANDFILL 2. CELL 3. PIPING 4. COLLECTION 5. LEACHATE

	BY	DATE
DESIGNED	TOCHER	6/14/94
DRAWN	WEDNER	6/14/94
CHECKED	McBRIEN	6/14/94
APPROVED	CAMPBELL	6/14/94
SUBMITTED	SPRENKLE	6/14/94

U.S. DEPARTMENT OF ENERGY
ROCKY FLATS OFFICE GOLDEN, COLORADO

Rocky Flats Plant
GOLDEN, COLORADO

NEW SANITARY LANDFILL
CELL NO. 1 - LEACHATE COLLECTION PIPING AND DETAILS

SIZE D | DRAWING NUMBER 51077-401 | ISSUE C | SHEET - OF -

MERRICK

COMPUTER GENERATED
NO MANUAL CHANGES ALLOWED

4/4